


1.4

1.5

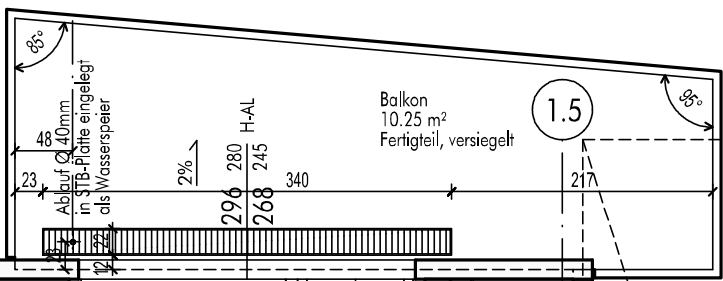

STUK = +268 RDOK  
RPH = RDOK  
FPH = FOK  
Innenjalousie

TOP 17  
WNFL 67.31 m<sup>2</sup>  
Balkon 10.25 m<sup>2</sup>  
RH 2.53 m

Wohnküche  
38.59 m<sup>2</sup>  
Teppich 33.31 m<sup>2</sup>  
Linoleum 5.28 m<sup>2</sup>

H: 120 cm

Innenjalousie  
STUK = +268 RDOK  
RPH = +131 RDOK  
FPH = +120 FOK

116 100 H-AL  
137 125

Glasfüllung

Bod 4.28 m<sup>2</sup>  
Fliese

WC 1.80 m<sup>2</sup>  
Fliese

Vorraum 9.60 m<sup>2</sup>  
Linoleum

Zimmer 13.04 m<sup>2</sup>  
Teppich

STUK = +223 RDOK  
RPH = +117 RDOK  
FPH = +100 FOK

216 200 H-AL  
112 100

